


2241
5 OF 7

REV. 13 AUG. 1980-SF
BY: SID FRAZIER 939-5419

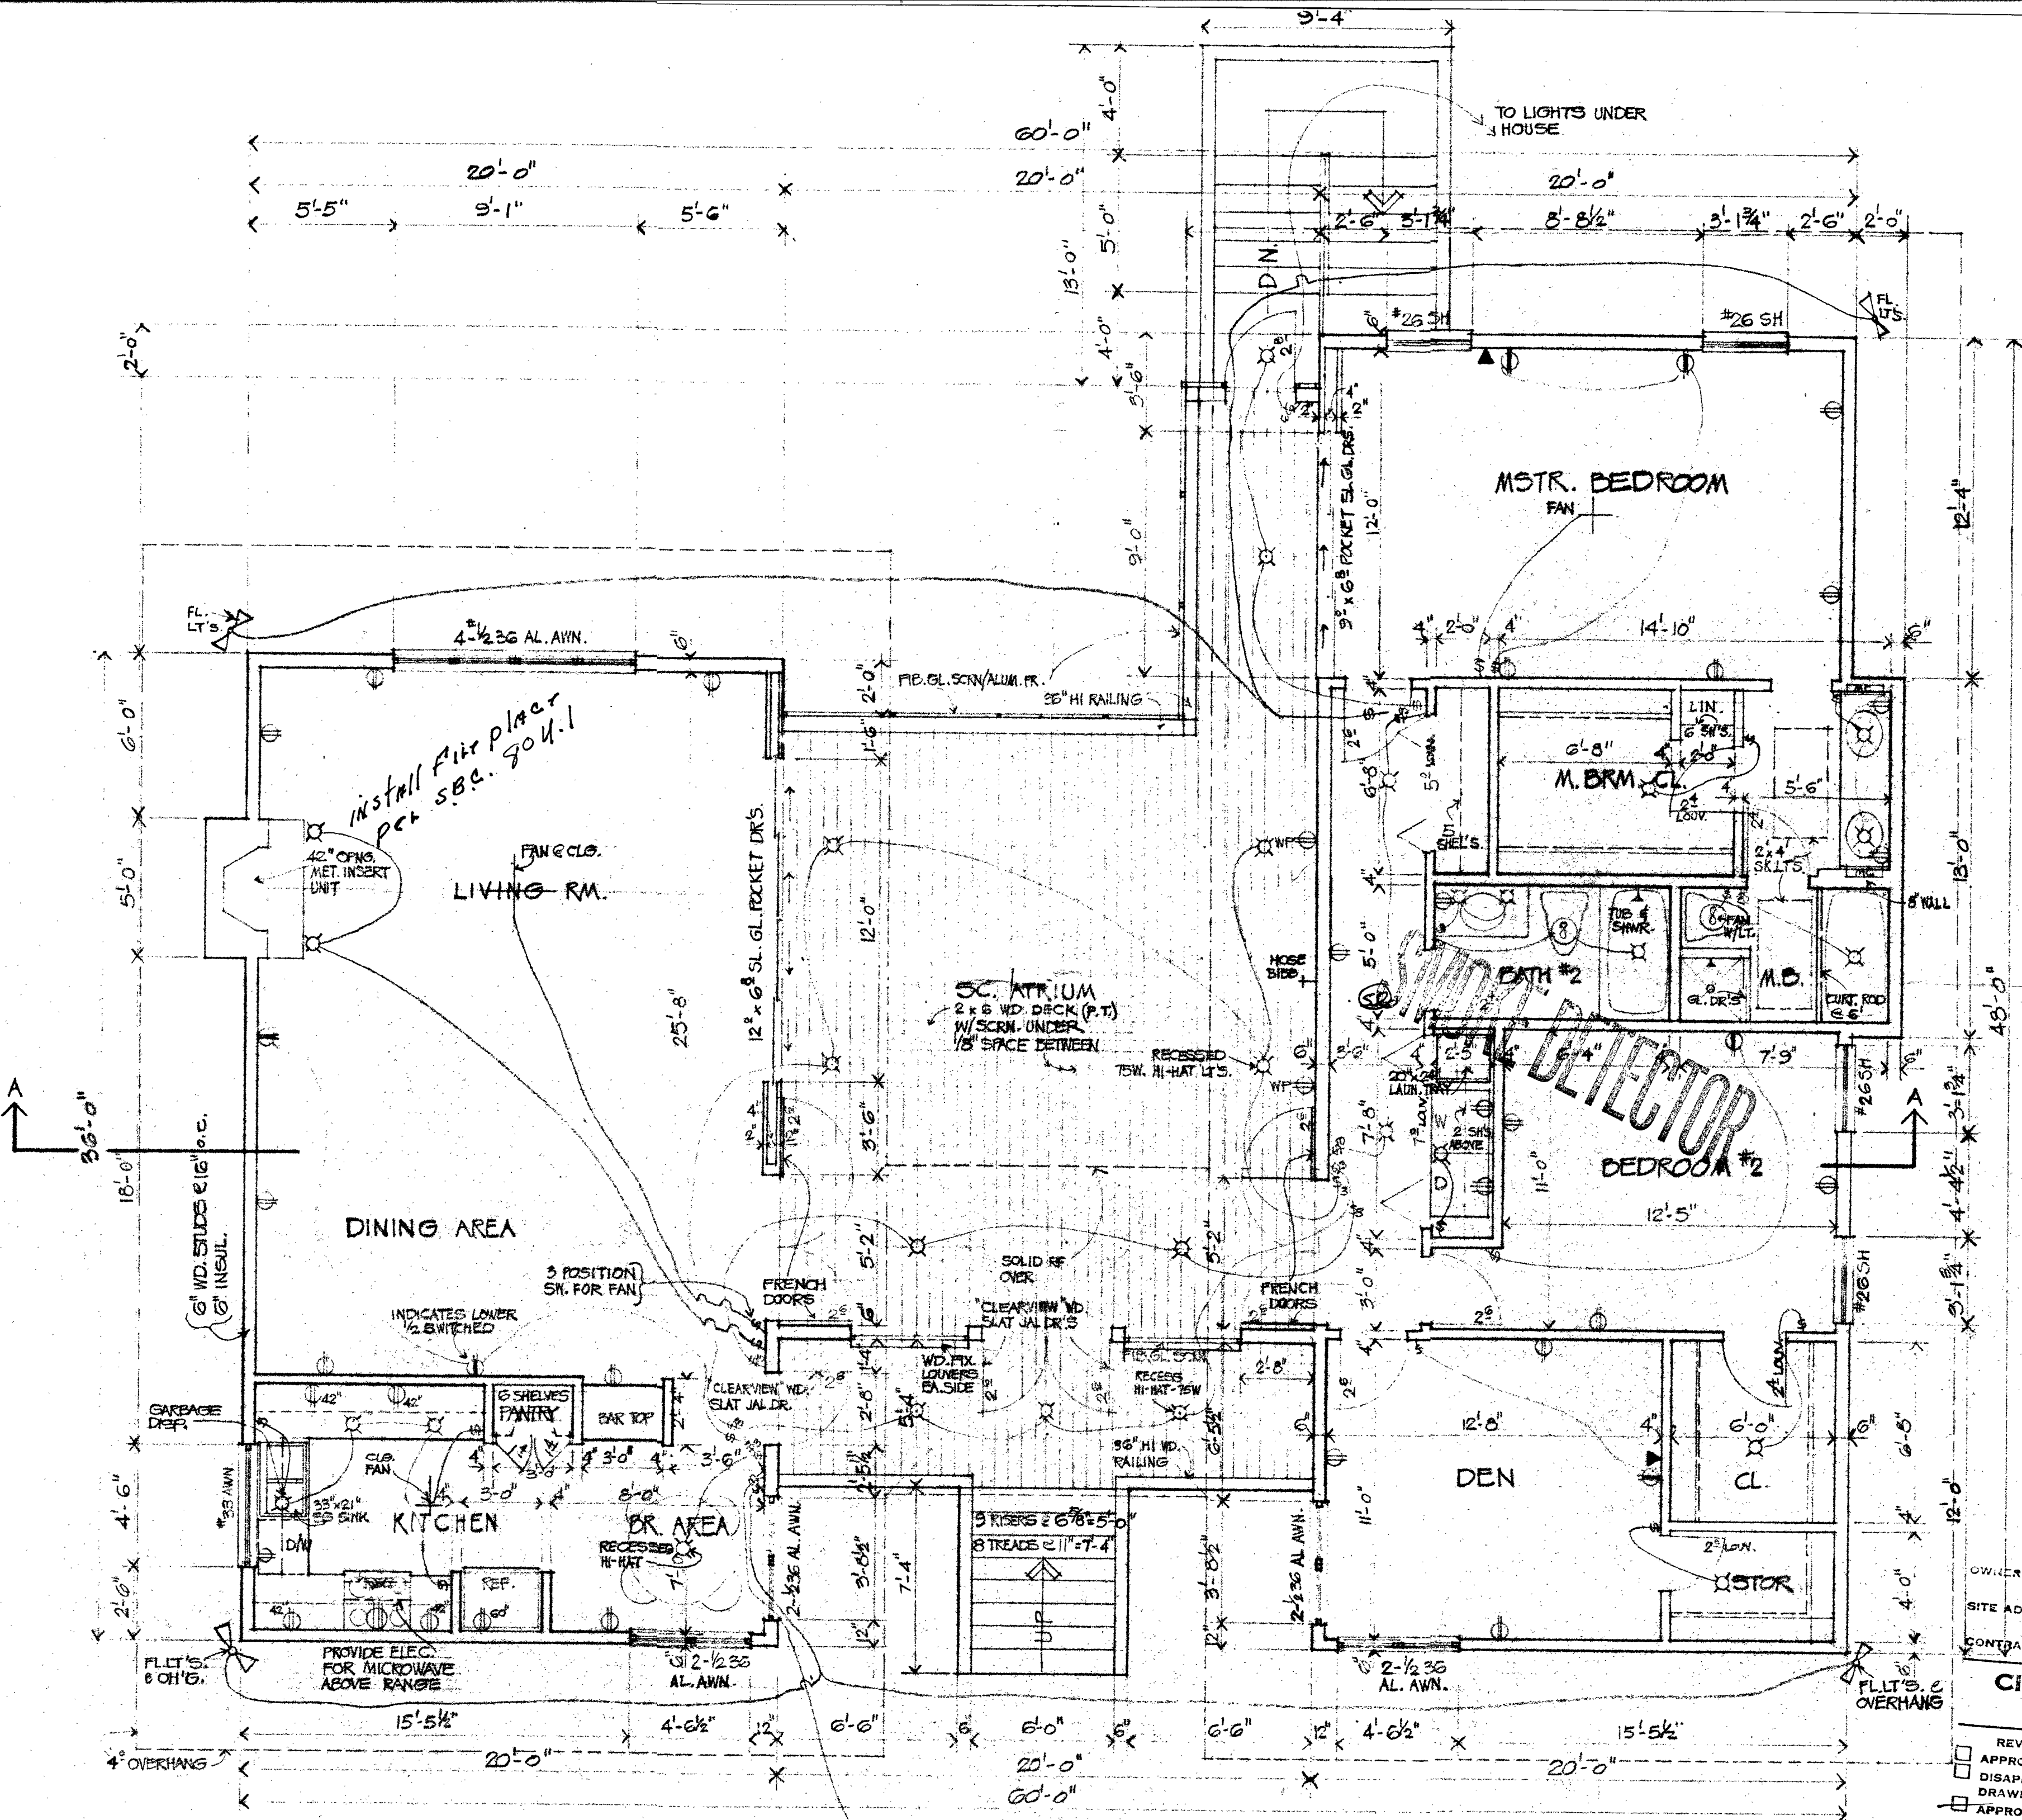

FLOOR PLAN
SCALE 1/4" = 1'-0"

NOTE: ALL ALUM. WD'S, ESP BRONZE FINISH.
" " SL. DR'S, ESP " " "

CITY OF SANIBEL ISLAND RESIDENCE
FLORIDA

OWNER _____
SITE ADDRESS _____
CONTRACTOR _____

CITY OF SANIBEL ISLAND BUILDING DEPARTMENT

REVIEWED AS INDICATED BELOW
 APPROVED FOR CONSTRUCTION
 DISAPPROVED - SUBMIT REVISED DRAWING FOR REVIEW
 APPROVED AS NOTED FOR CONSTRUCTION

PROCESSED BY 9-4-80 DATE _____

APPROVAL OF THIS DRAWING DOES NOT IMPLY ACCEPTANCE OF ANY MATERIAL OR EQUIPMENT NOT FULFILLING ALL DESIGN AND SPECIFICATION REQUIREMENTS.