


#6593
50F15

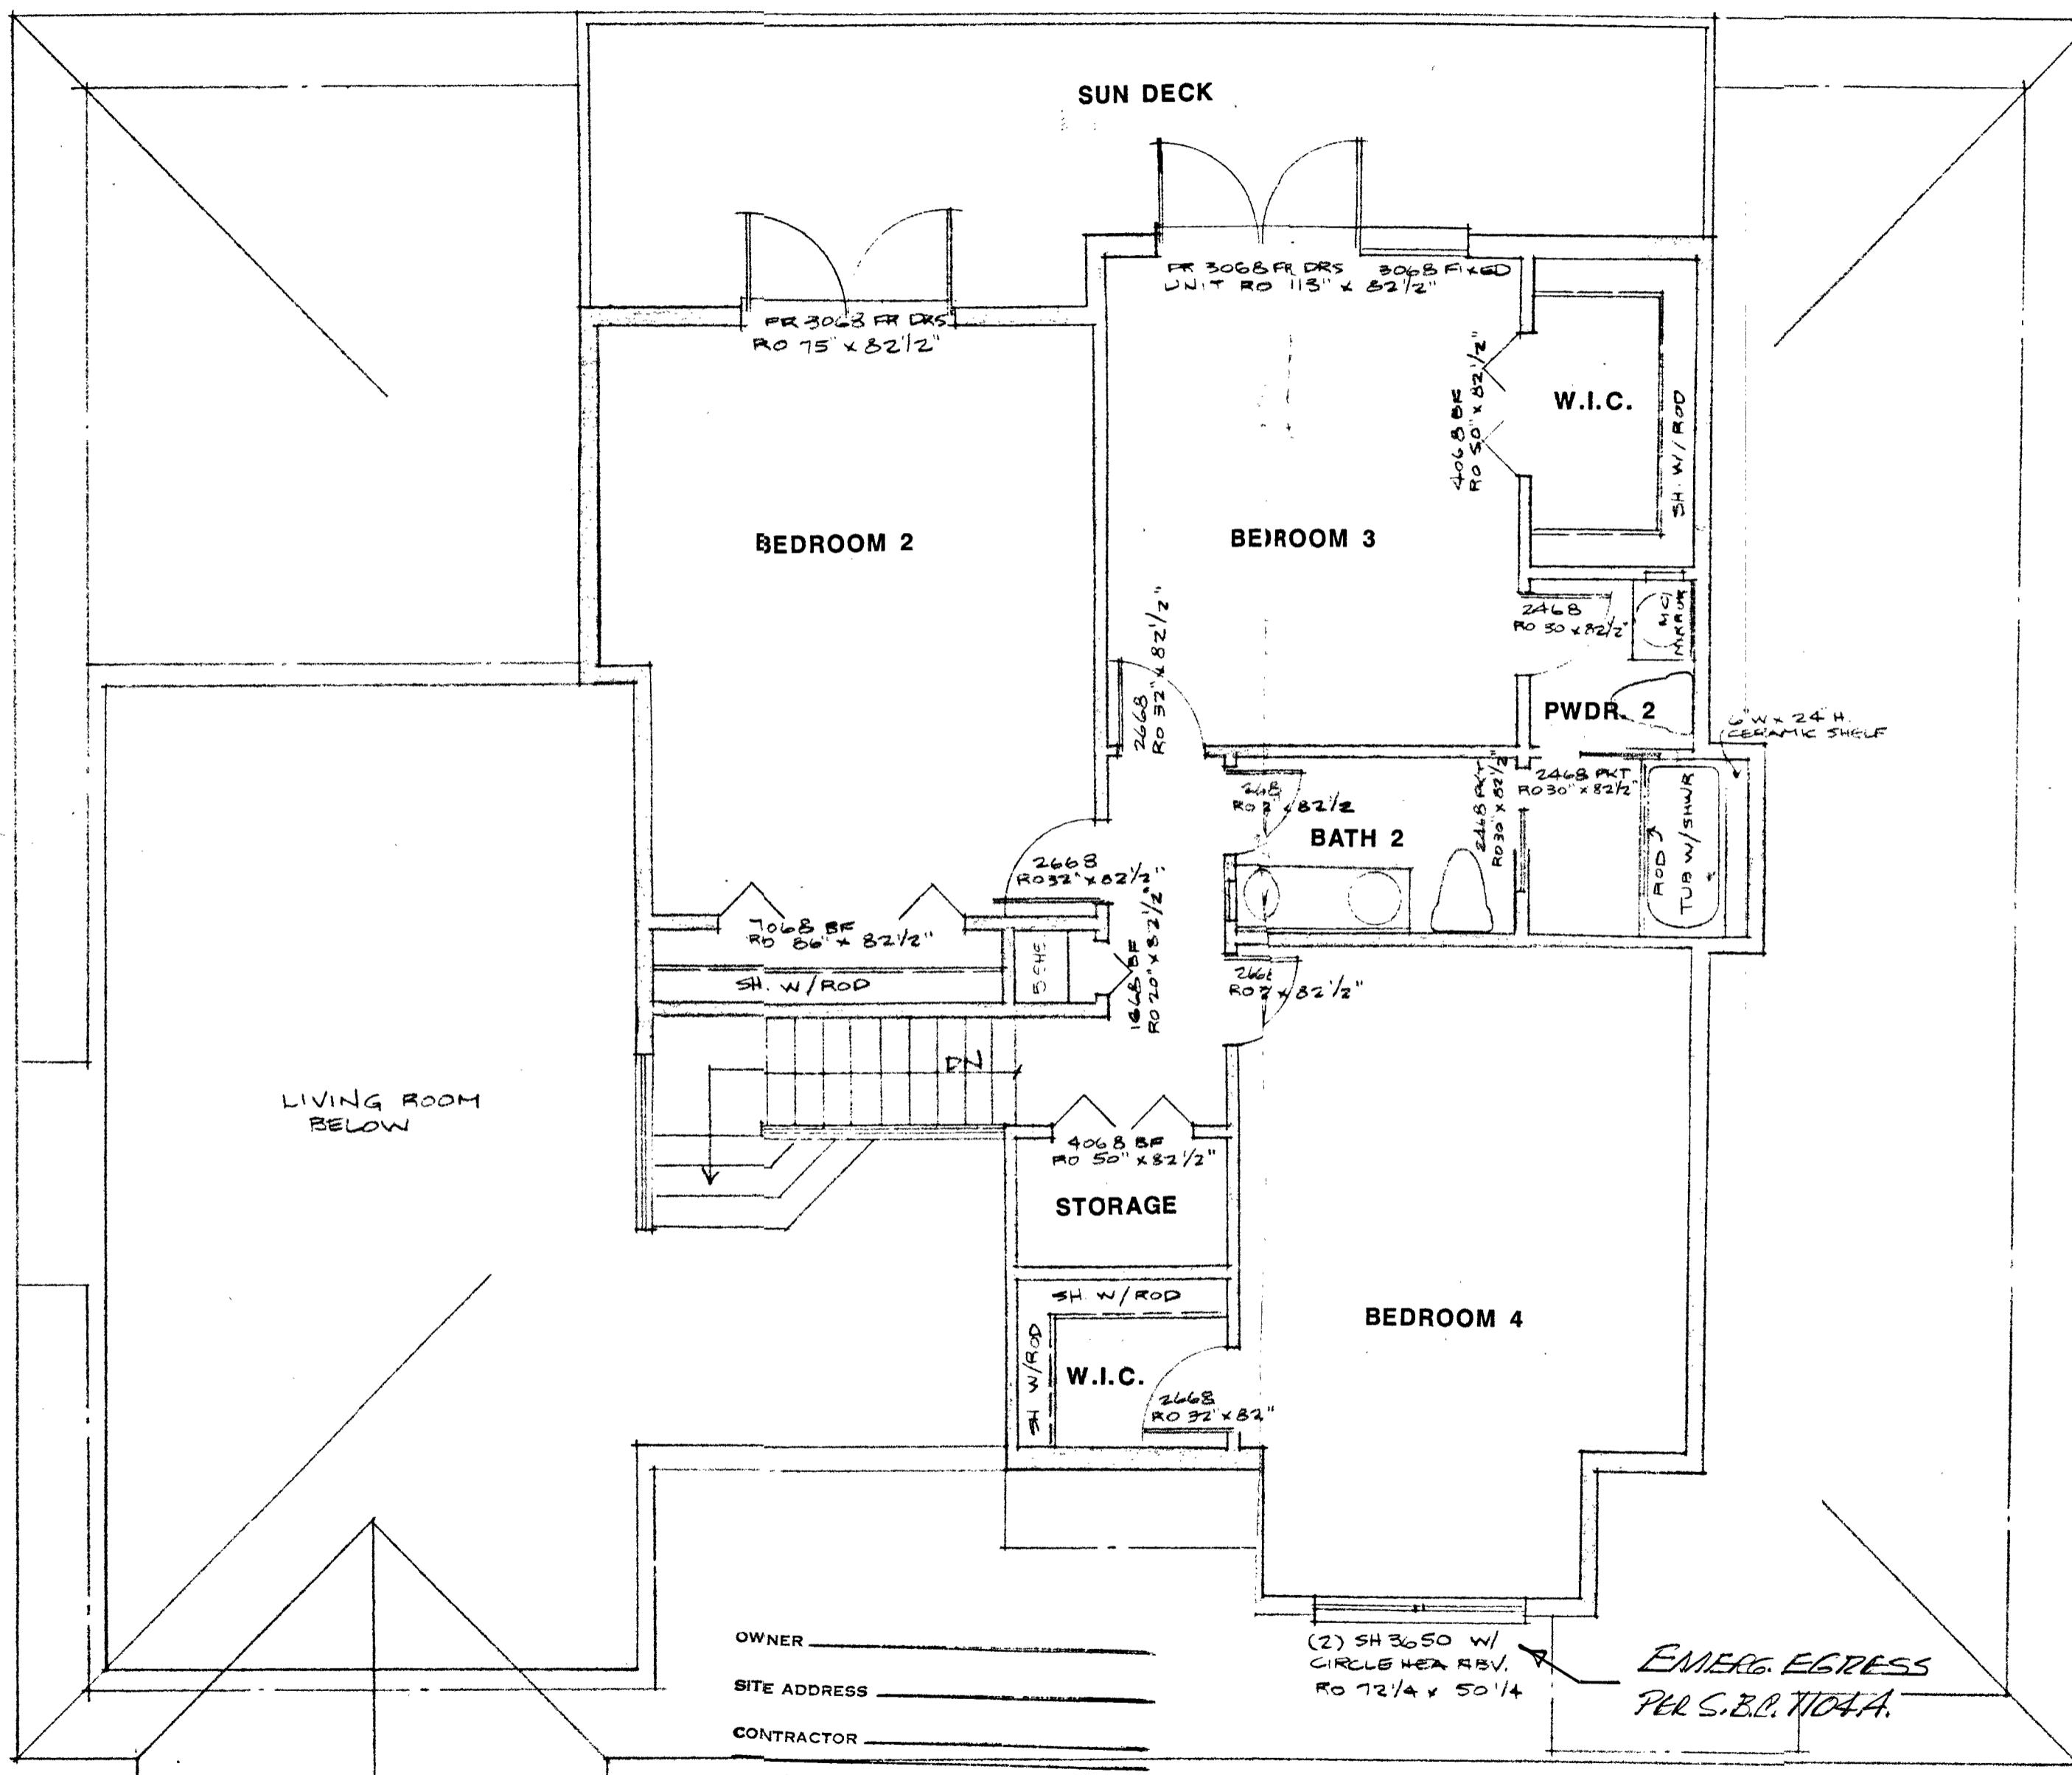

OWNER _____
 SITE ADDRESS _____
 CONTRACTOR _____

CITY OF SANIDEL
 BUILDING DEPARTMENT

- REVIEWED AS INDICATED BELOW
- APPROVED FOR CONSTRUCTION
- DISAPPROVED - SUBMIT REVISED DRAWING FOR REVIEW
- APPROVED AS NOTED FOR CONSTRUCTION

M. ANDERSON 5/20/07
 PROCESSED BY DATE

APPROVAL OF THIS DRAWING DOES NOT IMPLY
 ACCEPTANCE OF ANY MATERIAL OR EQUIPMENT
 NOT FULFILLING ALL DESIGN AND SPECIFICATION
 REQUIREMENTS.

CITY OF SANIDEL APPROVAL OF THE DRAWINGS
 OR THIS PROJECT DOES NOT RELIEVE THE
 OWNER FROM RESPONSIBILITY FOR
 COMPLIANCE WITH ALL PERTINENT CODES, LAWS,
 OR ORDINANCES.

Second Floor Plan

SCALE 1/4" = 1'-0"

A Residence By:
RIVERBEND HOMES, INC.
 6249 Presidential Court
 Fort Myers, Florida
 Phone: 482-1188

A Residence For:
M/M Redpath

Dan F. Sater II
 Residential Designer/482-4323

Job No.: 5408
Date: 1-21-07
Drawn By: CG

Sheet No.