


5443
3 of 11

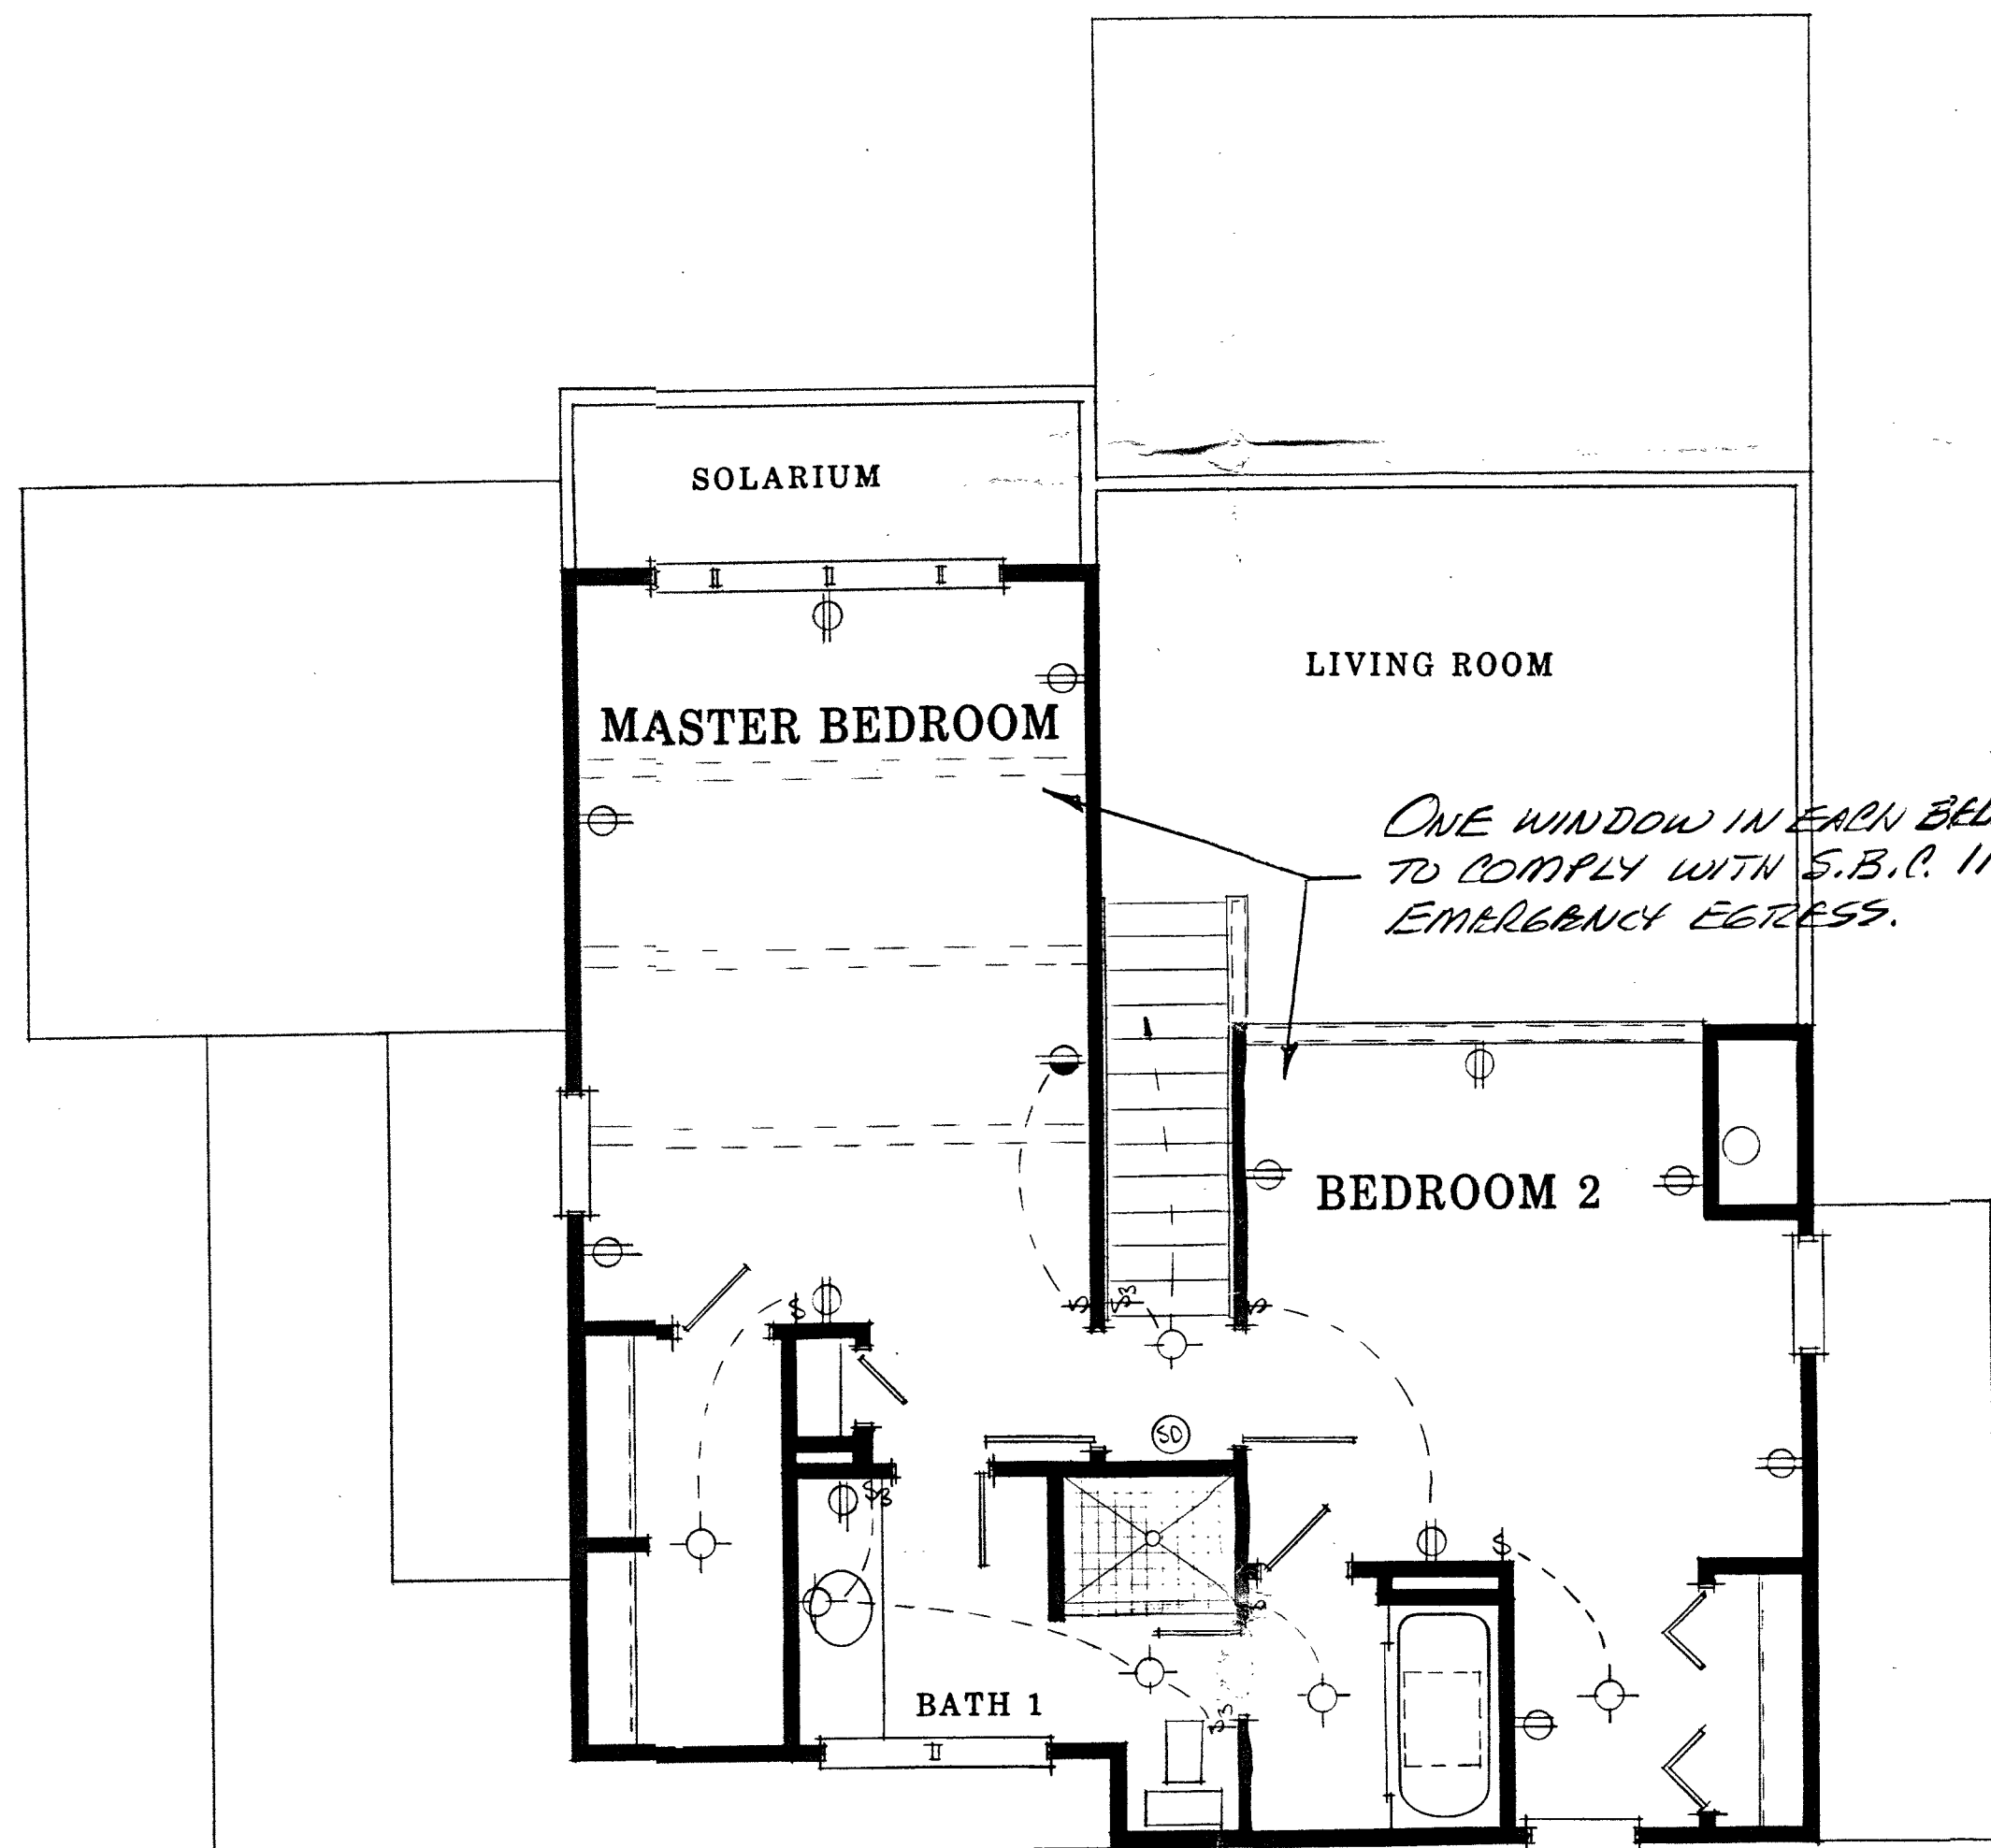

OWNER _____
 SITE ADDRESS _____
 CONTRACTOR _____

CITY OF SANIBEL
 BUILDING DEPARTMENT

- REVIEWED AS INDICATED BELOW
- APPROVED FOR CONSTRUCTION
- DISAPPROVED - SUBMIT REVISED DRAWING FOR REVIEW
- APPROVED AS NOTED FOR CONSTRUCTION

M. ANDERSON 1/20/86
 PROCESSED BY DATE

APPROVAL OF THIS DRAWING DOES NOT IMPLY ACCEPTANCE OF ANY MATERIAL OR EQUIPMENT NOT FULFILLING ALL DESIGN AND SPECIFICATION REQUIREMENTS.

CITY OF SANIBEL APPROVAL OF THE DRAWINGS FOR THIS PROJECT DOES NOT RELIEVE THE PERMIT HOLDER FROM RESPONSIBILITY FOR COMPLIANCE WITH ALL PERTINENT CODES, LAWS, OR ORDINANCES.

SECOND FLOOR PLAN

SCALE - 1/4" = 1'-0"

SANIBEL HOMES
 A RESIDENCE FOR
 MR. & MRS. McGUIRE

THERO ATC# JOB# 598
 ACOBAN 3/8